


**BADEGROW BUILDING
SIOUX CITY, IOWA**

**DOUGLAS J. STEINMETZ
ARCHITECT**
*American Institute of Architects
National Council of Architectural Registration Boards Certified*
Phone: 319 - 294 - 4905 4121 Timberview Drive NE
Fax: 319 - 892 - 0568 Cedar Rapids, Iowa 52411
doug@djsaia.com ■ ■ ■ ■ ■

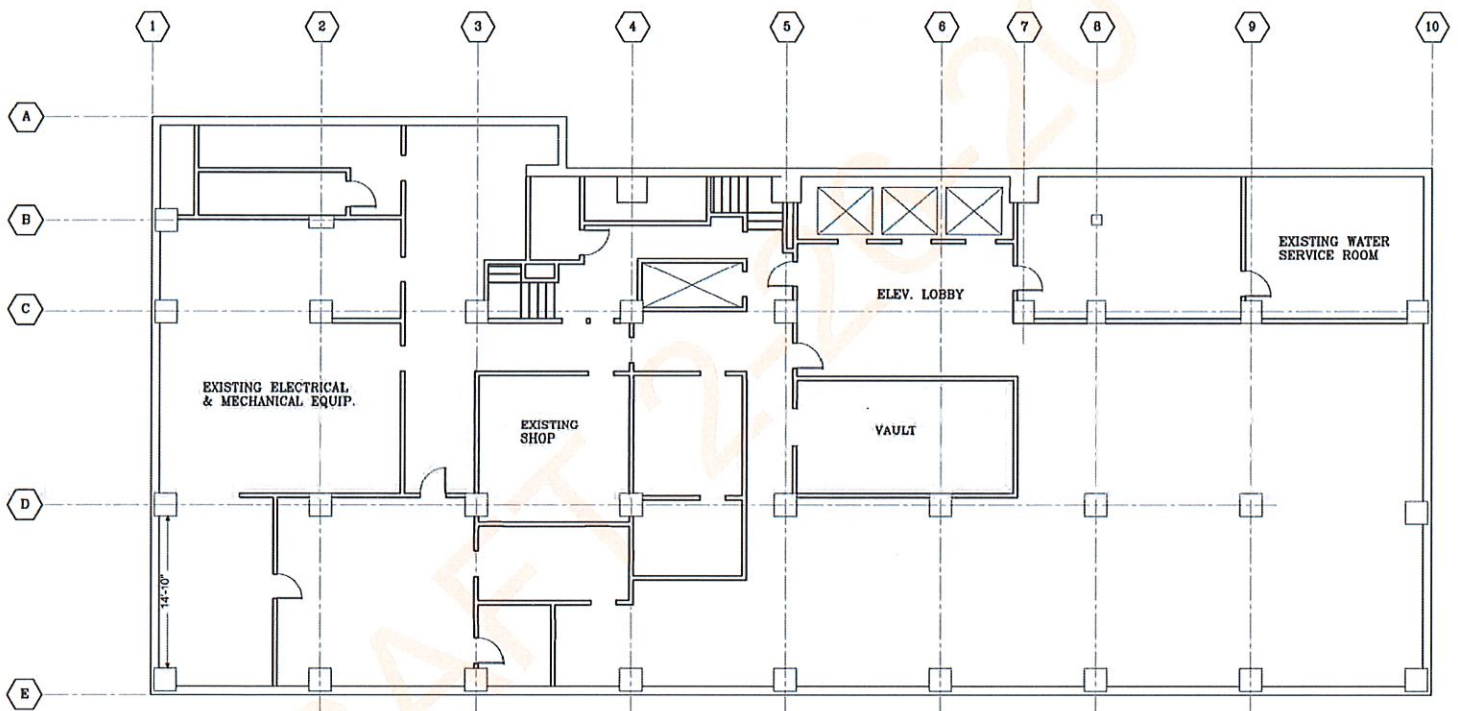


JANUARY 2018
ITC 21,648 (IA-2009-040)

BASEMENT PLAN 
PART 3 ITC REMEDIAL WORK
LIGHTHOUSE PROPERTY MANAGEMENT

DRAFT PAGE 6 of 55

**BADEGROW BUILDING
SIOUX CITY, IOWA**

**DOUGLAS J. STEINMETZ
ARCHITECT**
*American Institute of Architects
National Council of Architectural Registration Boards Certified*
Phone: 319 - 294 - 4905 4121 Timberview Drive NE
Fax: 319 - 892 - 0568 Cedar Rapids, Iowa 52411
doug@djsaia.com ■ ■ ■ ■ ■

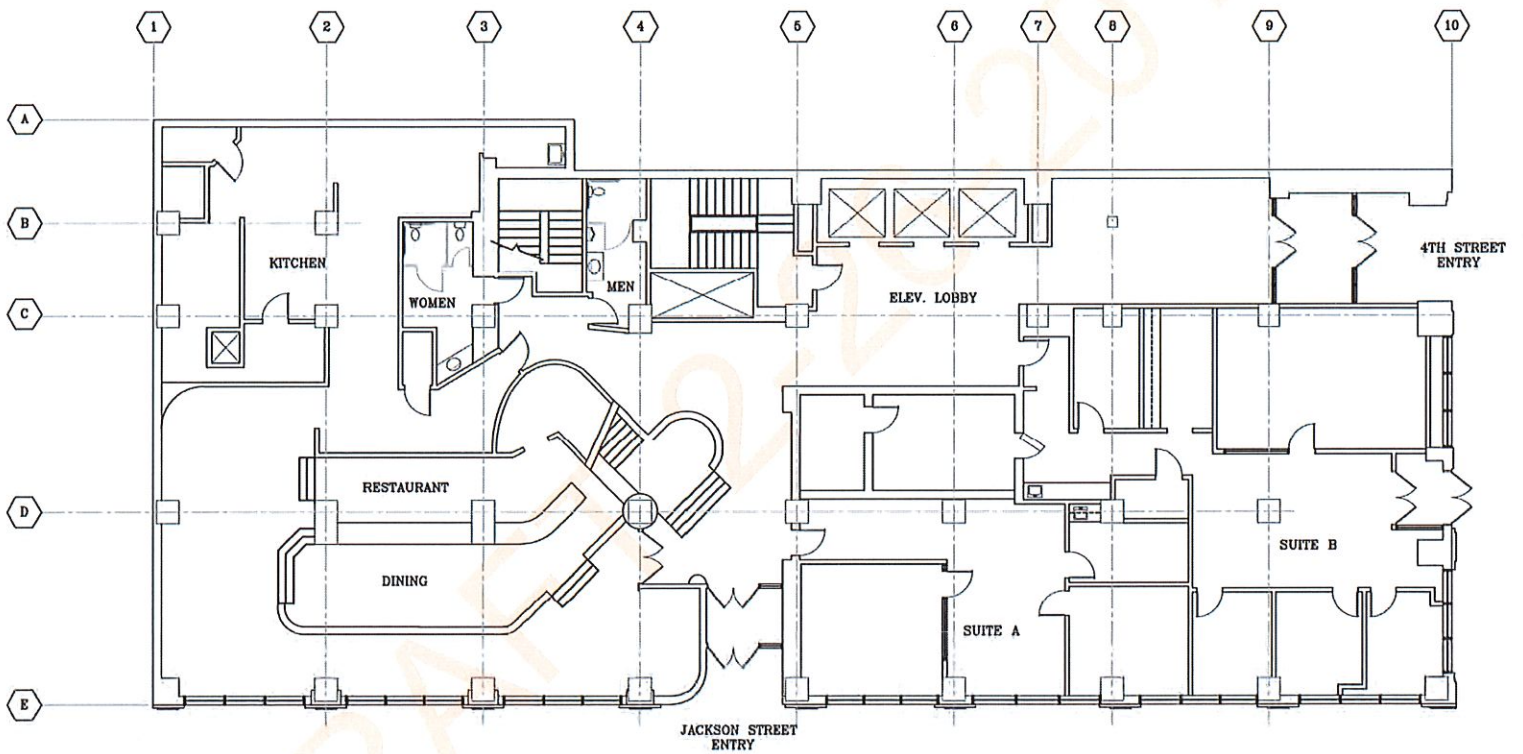


JANUARY 2018
ITC 21,648 (IA-2009-040)

MAIN FLOOR PLAN 
**PART 3 ITC REMEDIAL WORK
LIGHTHOUSE PROPERTY MANAGEMENT**

DRAFT PAGE 7 of 55

**BADEGROW BUILDING
SIOUX CITY, IOWA**

**DOUGLAS J. STEINMETZ
ARCHITECT**
*American Institute of Architects
National Council of Architectural Registration Boards Certified*
Phone: 319-294-4905 4121 Timberview Drive NE
Fax: 319-892-0508 Cedar Rapids, Iowa 52411
doug@djsaia.com ■ ■ ■ ■ ■

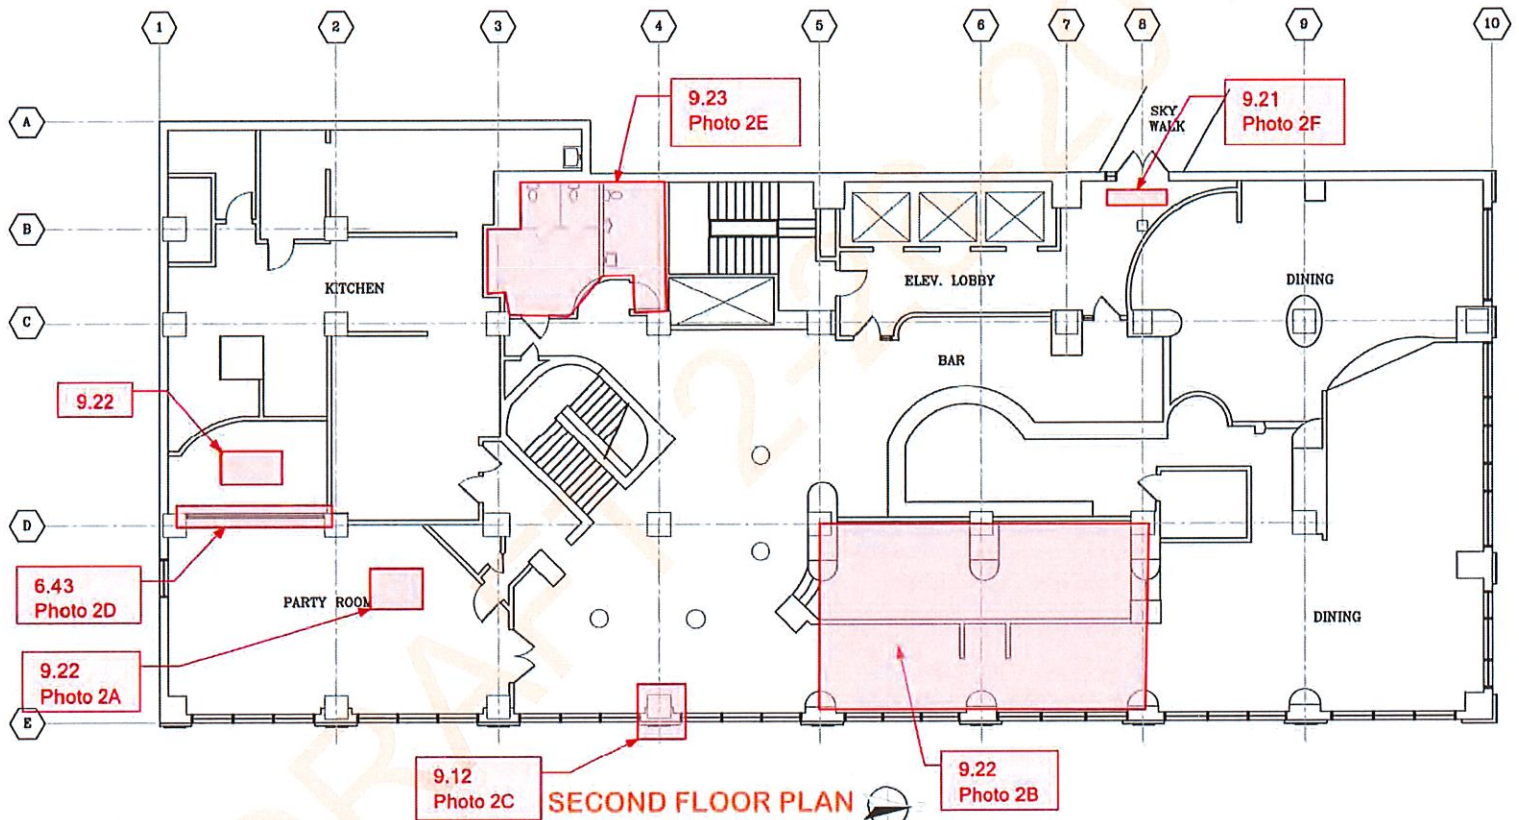


JANUARY 2018
ITC 21,648 (IA-2009-040)

SECOND FLOOR PLAN
PART 3 ITC REMEDIAL WORK
LIGHTHOUSE PROPERTY MANAGEMENT

DOUGLAS J. STEINMETZ
A R C H I T E C T
American Institute of Architects
National Council of Architectural Registration Boards Certified
 Phone: 319 • 294 • 4905 4121 Timberview Drive NE
 Fax: 319 • 892 • 0568 Cedar Rapids, Iowa 52411
 doug@djsaia.com ■ ■ ■ ■ ■

**BADEGROW BUILDING
 SIOUX CITY, IOWA**

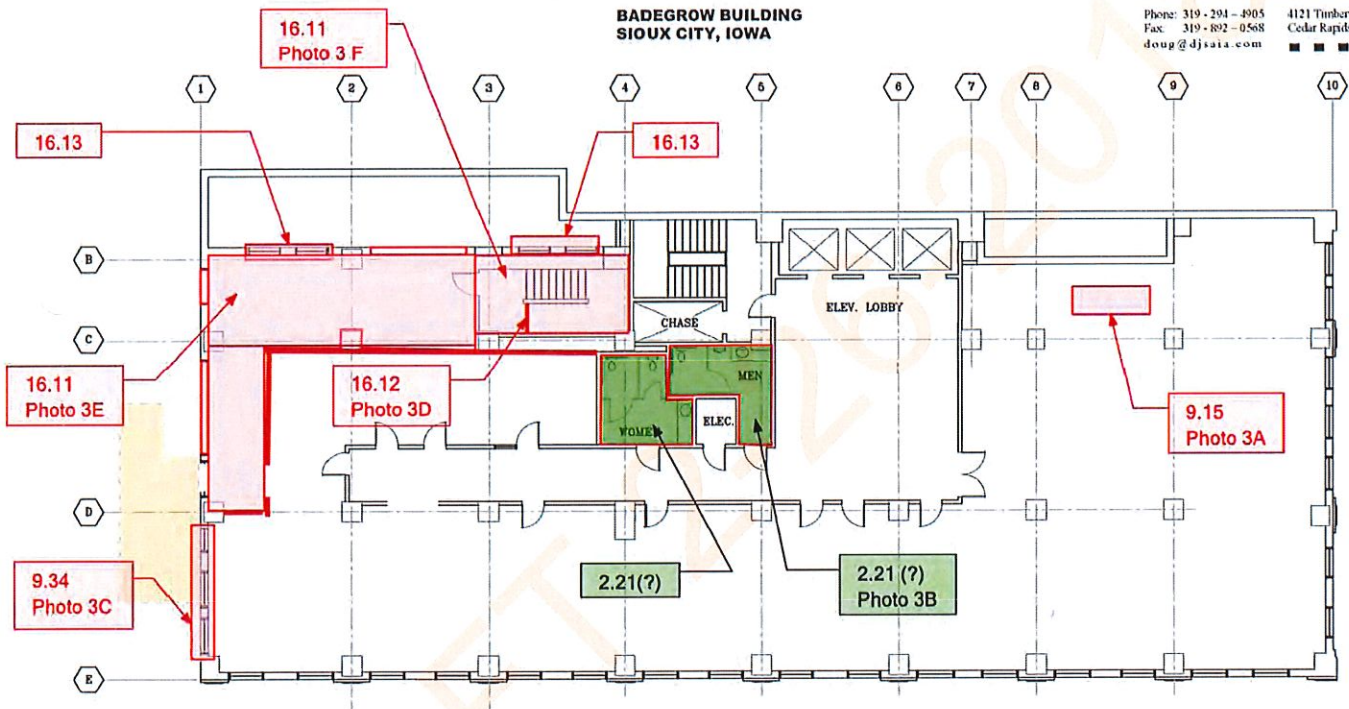

THIRD FLOOR PLAN




JANUARY 2018
 ITC 21,648 (IA-2009-040)

**PART 3 ITC REMEDIAL WORK
 LIGHTHOUSE PROPERTY MANAGEMENT**

DRAFT PAGE 9 of 55

**BADEGROW BUILDING
SIOUX CITY, IOWA**

**DOUGLAS J. STEINMETZ
ARCHITECT**
*American Institute of Architects
National Council of Architectural Registration Boards Certified*
Phone: 319 - 294 - 4905 4121 Timberview Drive NE
Fax: 319 - 892 - 0588 Cedar Rapids, Iowa 52411
doug@djsaia.com ■ ■ ■ ■ ■

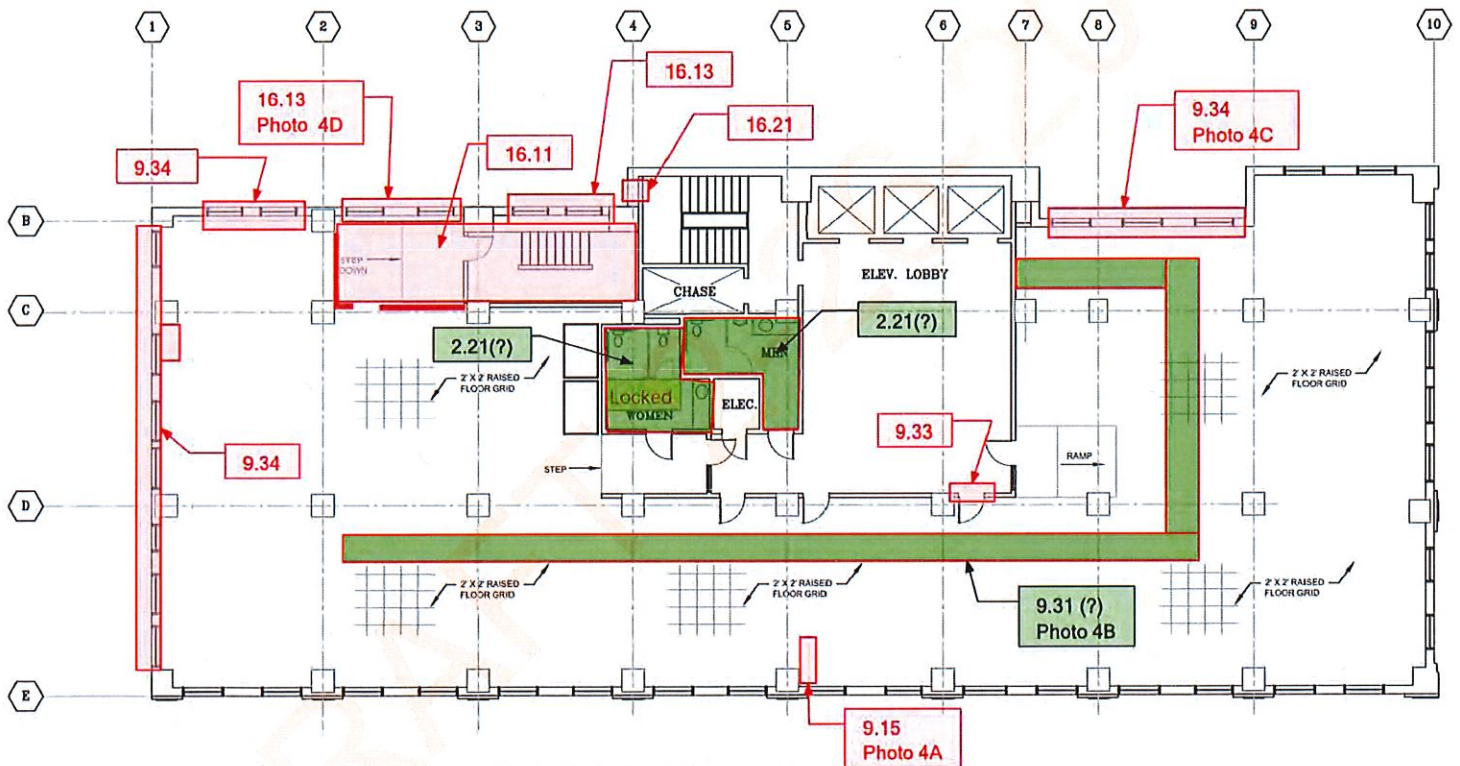

FOURTH FLOOR PLAN


JANUARY 2018
ITC 21,648 (IA-2009-040)

**PART 3 ITC REMEDIAL WORK
LIGHTHOUSE PROPERTY MANAGEMENT**

DRAFT PAGE 10 of 55

**BADEGROW BUILDING
SIOUX CITY, IOWA**

**DOUGLAS J. STEINMETZ
ARCHITECT**
*American Institute of Architects
National Council of Architectural Registration Boards Certified*
Phone: 319 - 294 - 4905 4121 Timberview Drive NE
Fax: 319 - 892 - 0568 Cedar Rapids, Iowa 52411
doug@djsaia.com ■ ■ ■ ■ ■

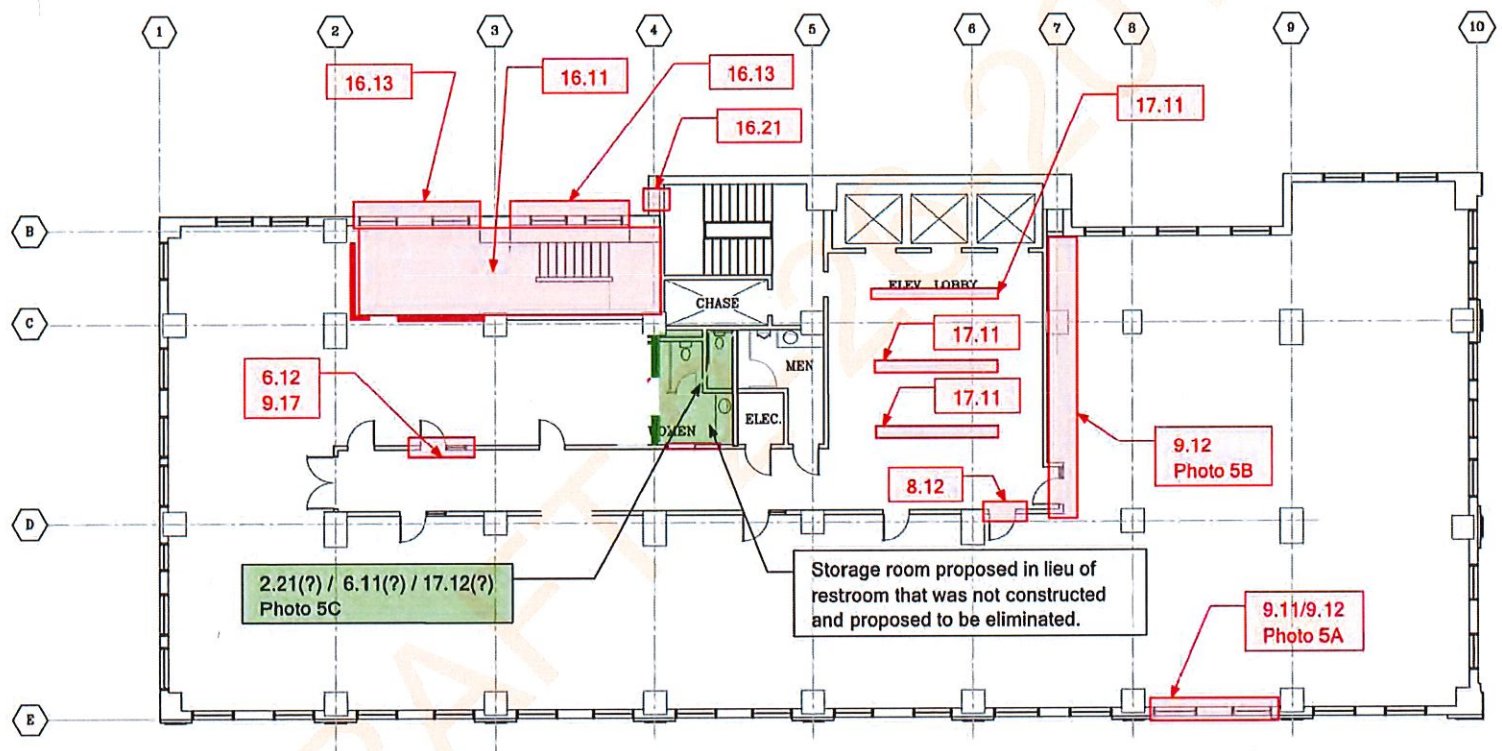


FIFTH FLOOR PLAN
**PART 3 ITC REMEDIAL WORK
LIGHTHOUSE PROPERTY MANAGEMENT**

**JANUARY 2018
ITC 21,648 (IA-2009-040)**

**BADEGROW BUILDING
SIOUX CITY, IOWA**

**DOUGLAS J. STEINMETZ
ARCHITECT**
*American Institute of Architects
National Council of Architectural Registration Boards Certified*
Phone: 319 - 294 - 4905 4121 Timberview Drive NE
Fax: 319 - 892 - 0568 Cedar Rapids, Iowa 52411
doug@djsaia.com ■ ■ ■ ■ ■

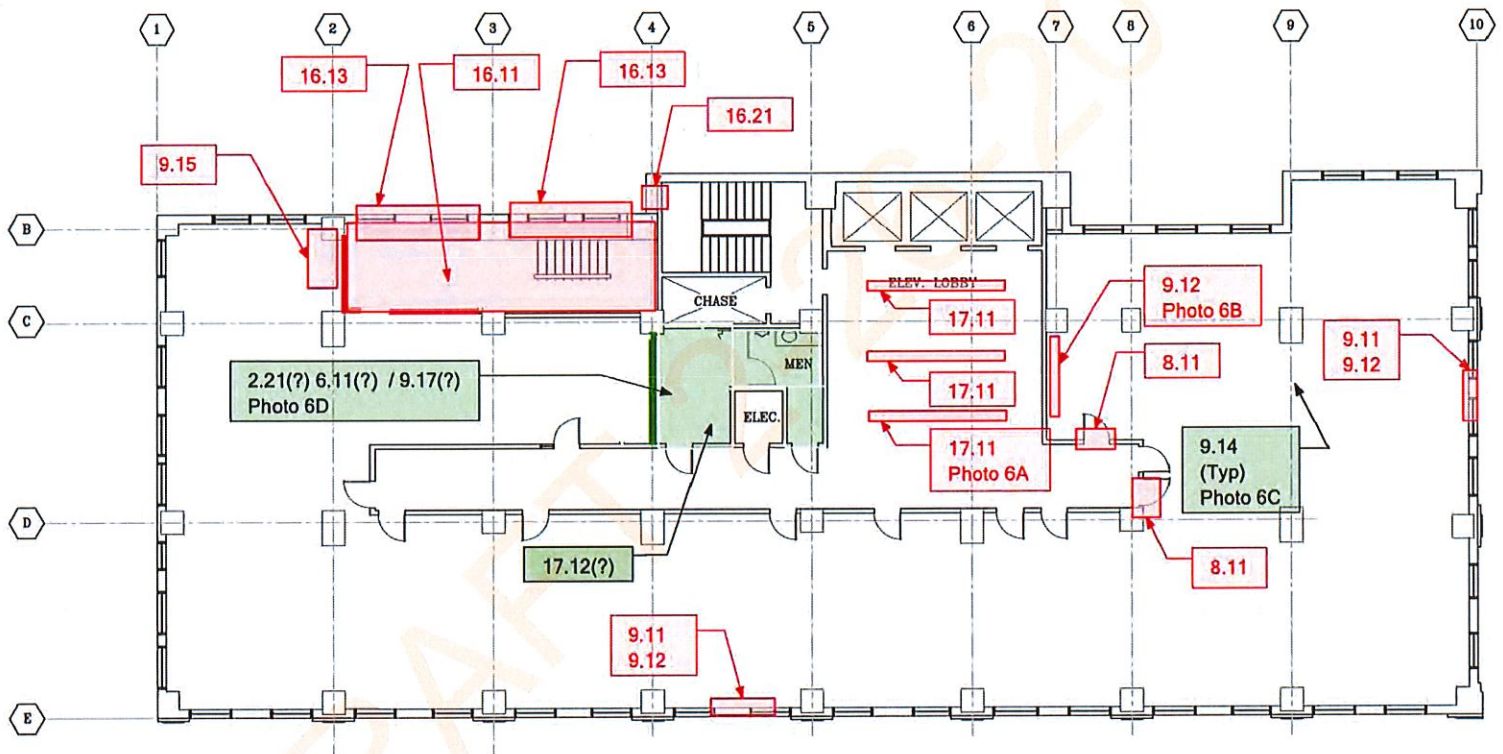


JANUARY 2018
ITC 21,648 (IA-2009-040)

SIXTH FLOOR PLAN 
**PART 3 ITC REMEDIAL WORK
LIGHTHOUSE PROPERTY MANAGEMENT**

DRAFT PAGE 12 of 55

**BADEGROW BUILDING
SIOUX CITY, IOWA**

**DOUGLAS J. STEINMETZ
ARCHITECT**
*American Institute of Architects
National Council of Architectural Registration Boards Certified*
Phone: 319 - 294 - 4905 4121 Timberview Drive NE
Fax: 319 - 892 - 0568 Cedar Rapids, Iowa 52411
doug@djsaia.com ■ ■ ■ ■ ■

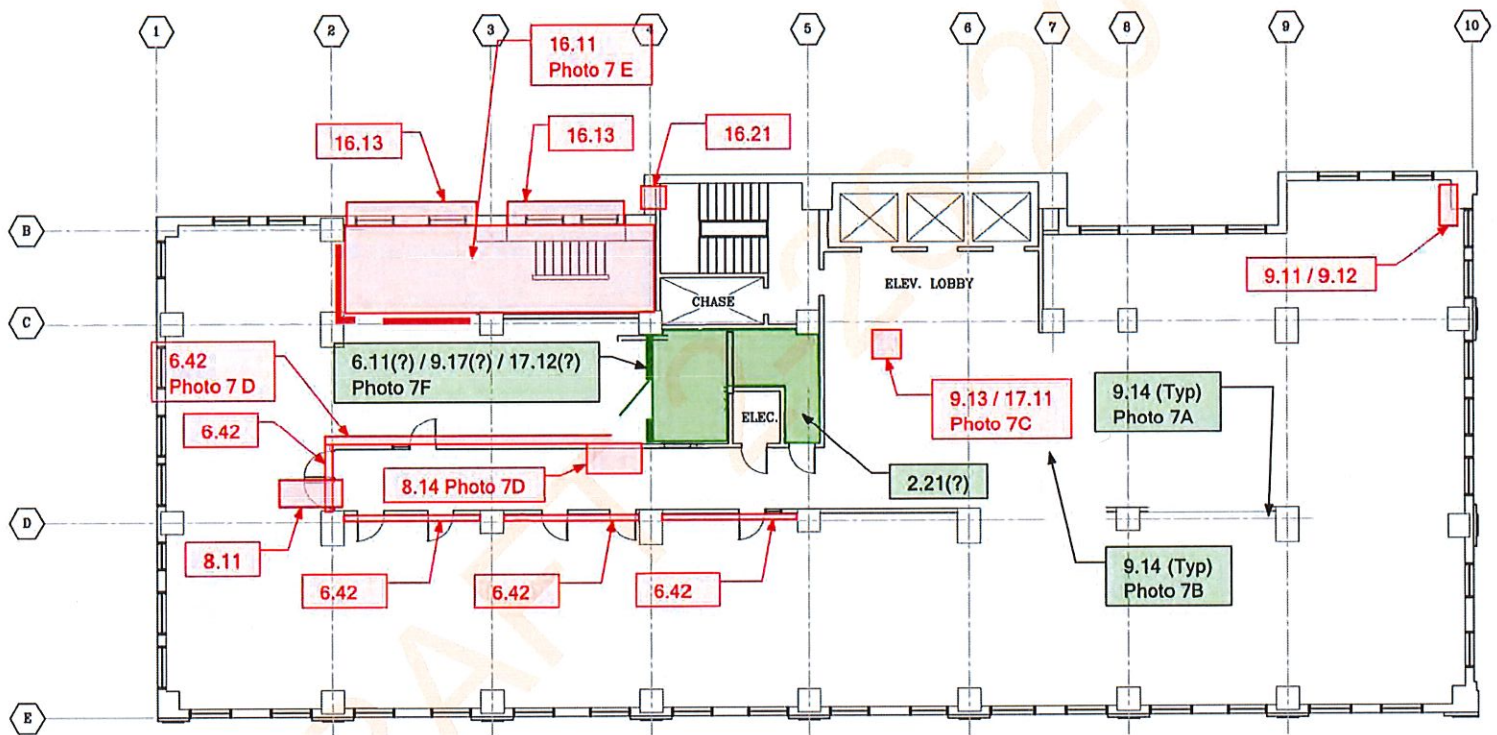

SEVENTH FLOOR PLAN




JANUARY 2018
ITC 21,648 (IA-2009-040)

**PART 3 ITC REMEDIAL WORK
LIGHTHOUSE PROPERTY MANAGEMENT**

DRAFT PAGE 13 of 55

**BADEGROW BUILDING
SIOUX CITY, IOWA**

**DOUGLAS J. STEINMETZ
ARCHITECT**
*American Institute of Architects
National Council of Architectural Registration Boards Certified*
Phone: 319 - 294 - 4905 4121 Timberview Drive NE
Fax: 319 - 892 - 0568 Cedar Rapids, Iowa 52411
doug@djsaia.com ■ ■ ■ ■ ■ ■ ■ ■ ■ ■

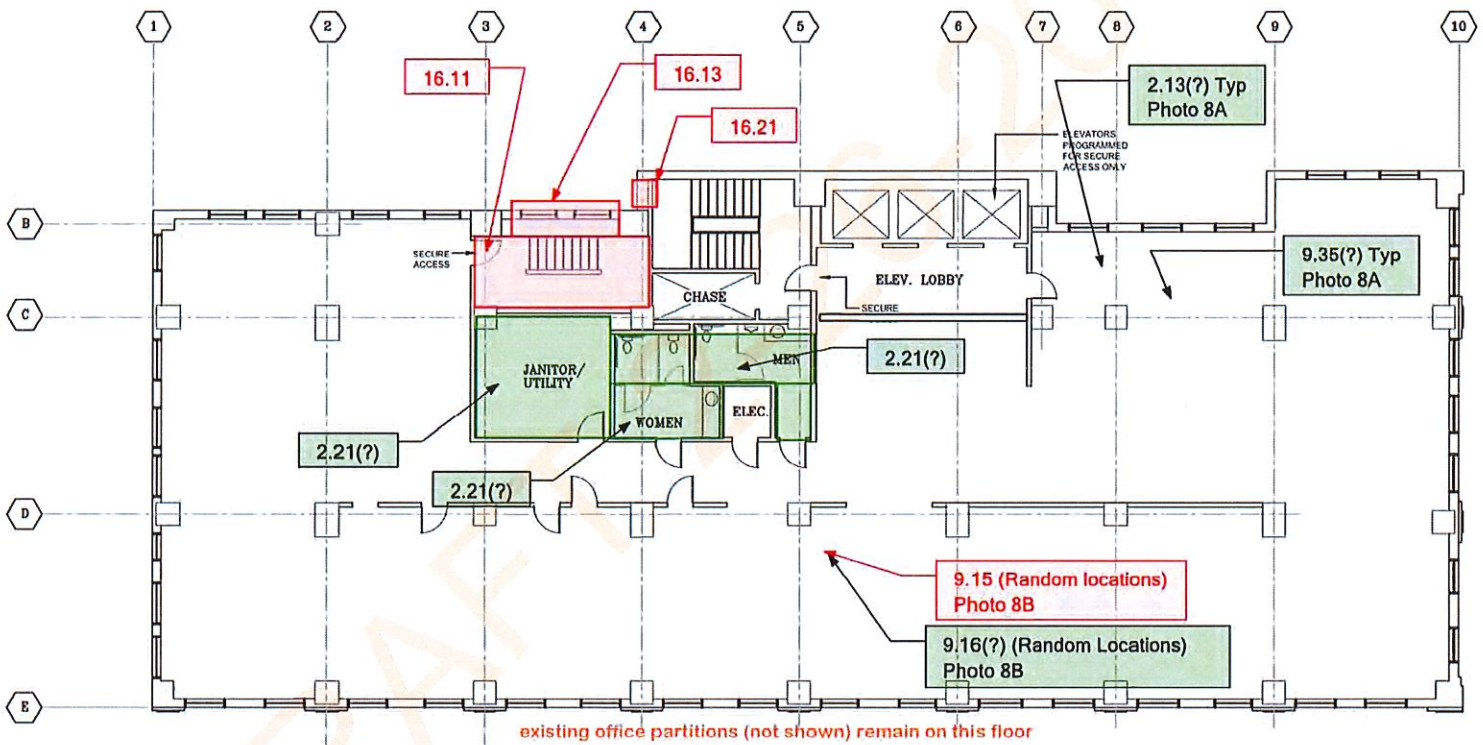


EIGHTH FLOOR PLAN
PART 3 ITC REMEDIAL WORK
LIGHTHOUSE PROPERTY MANAGEMENT

JANUARY 2018
ITC 21,648 (IA-2009-040)

**BADEGROW BUILDING
SIOUX CITY, IOWA**

**DOUGLAS J. STEINMETZ
ARCHITECT**
*American Institute of Architects
National Council of Architectural Registration Boards Certified*
Phone: 319-294-4905 4121 Turberview Drive NE
Fax: 319-892-0568 Cedar Rapids, Iowa 52411
doug@djsaia.com ■ ■ ■ ■ ■

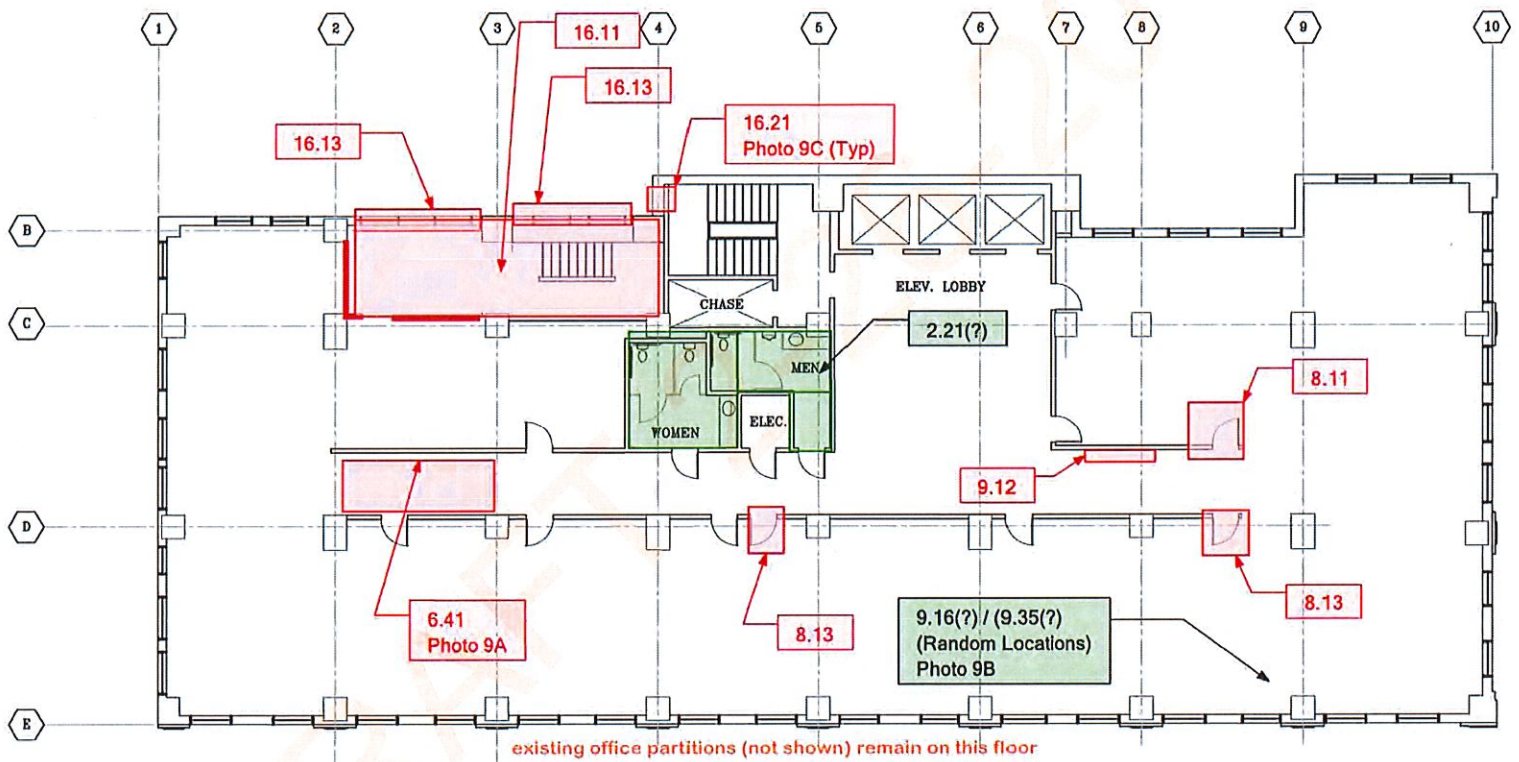

NINTH FLOOR PLAN


**PART 3 ITC REMEDIAL WORK
LIGHTHOUSE PROPERTY MANAGEMENT**



**JANUARY 2018
ITC 21,648 (IA-2009-040)**

**BADEGROW BUILDING
SIOUX CITY, IOWA**

**DOUGLAS J. STEINMETZ
ARCHITECT**
*American Institute of Architects
National Council of Architectural Registration Boards Certified*
Phone: 319 - 294 - 4905 4121 Timberview Drive NE
Fax: 319 - 892 - 0568 Cedar Rapids, Iowa 52411
doug@djsaia.com ■ ■ ■ ■ ■

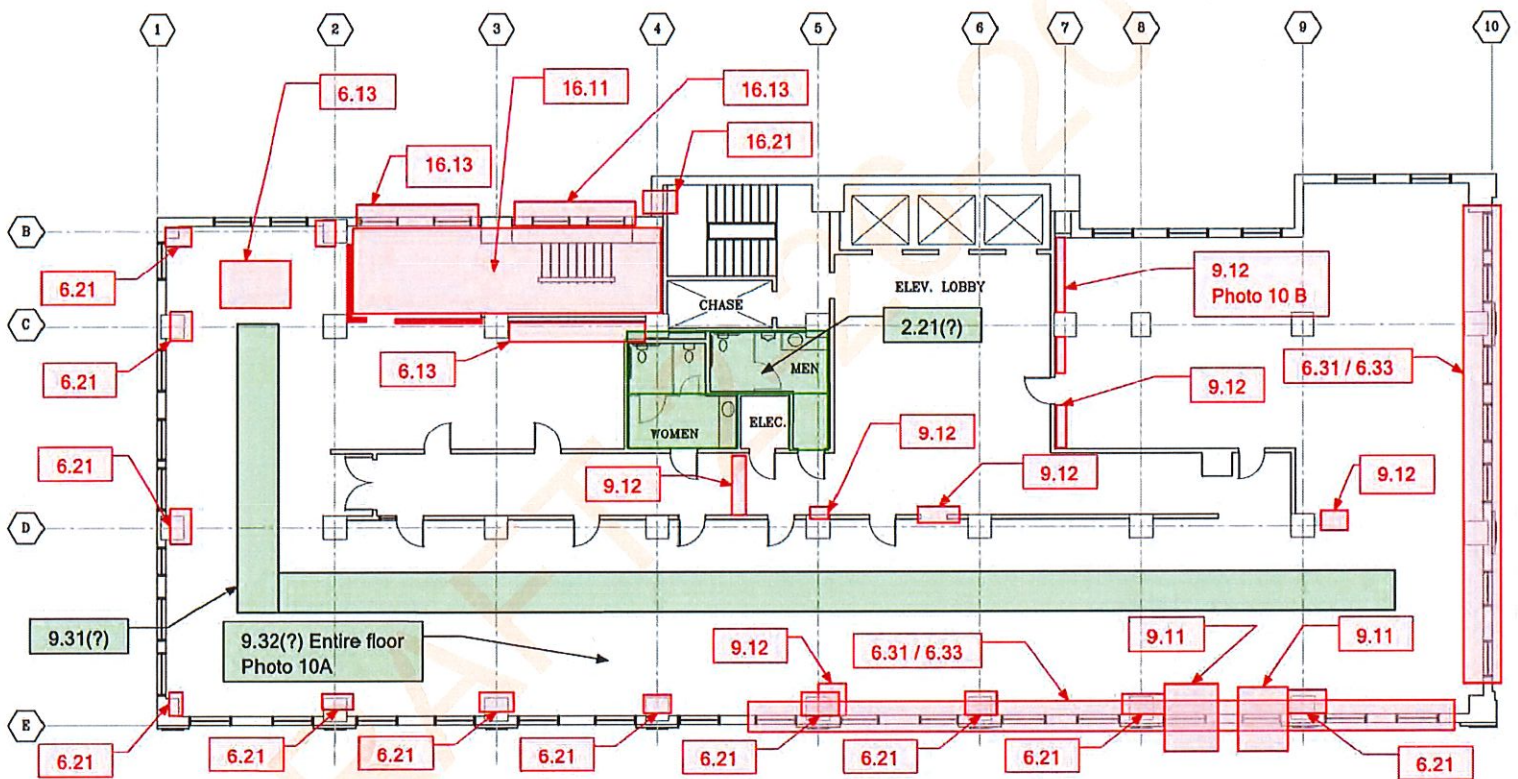

TENTH FLOOR PLAN


**PART 3 ITC REMEDIAL WORK
LIGHTHOUSE PROPERTY MANAGEMENT**

**JANUARY 2018
ITC 21,648 (IA-2009-040)**

DOUGLAS J. STEINMETZ
A R C H I T E C T
*American Institute of Architects
National Council of Architectural Registration Boards Certified*

Phone: 319-294-4905
Fax: 319-892-0568
doug@djsaia.com


4121 Timberview Drive NE
Cedar Rapids, Iowa 52411

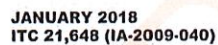

**PART 3 ITC REMEDIAL WORK
LIGHTHOUSE PROPERTY MANAGEMENT**

**BADEGROW BUILDING
SIOUX CITY, IOWA**

**DOUGLAS J. STEINMETZ
ARCHITECT**
*American Institute of Architects
National Council of Architectural Registration Boards Certified*
Phone: 319-291-4965 4121 Timberview Drive NE
Fax: 319-892-0568 Cedar Rapids, Iowa 52411
doug@djsaia.com ■ ■ ■ ■ ■

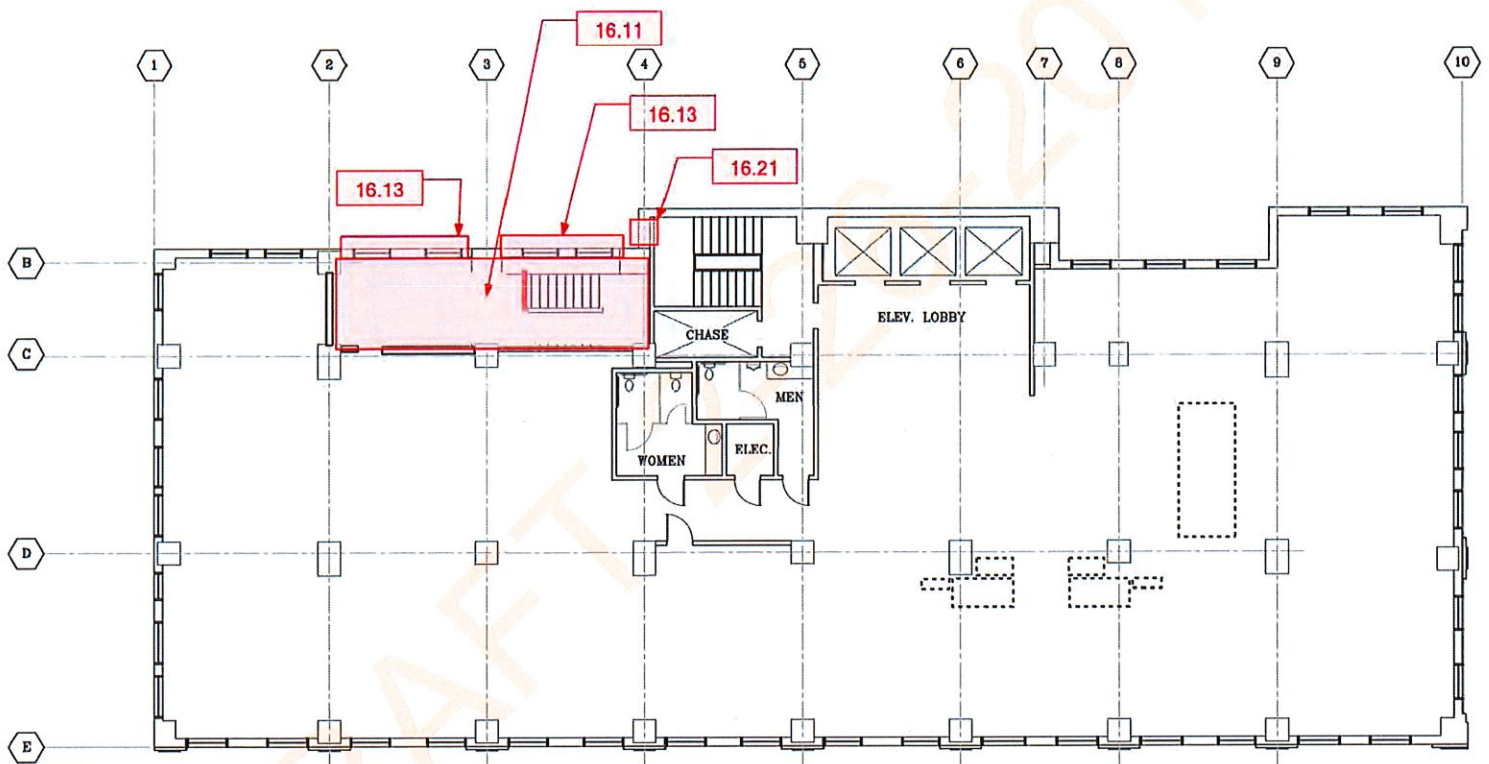


TWELFTH FLOOR PLAN
**PART 3 ITC REMEDIAL WORK
LIGHTHOUSE PROPERTY MANAGEMENT**

**JANUARY 2018
ITC 21,648 (IA-2009-040)**

**BADEGROW BUILDING
SIOUX CITY, IOWA**

**DOUGLAS J. STEINMETZ
ARCHITECT**
*American Institute of Architects
National Council of Architectural Registration Boards Certified*
Phone: 319 - 294 - 4905 4121 Timberview Drive NE
Fax: 319 - 892 - 0568 Cedar Rapids, Iowa 52411
doug@djsaia.com ■ ■ ■ ■ ■

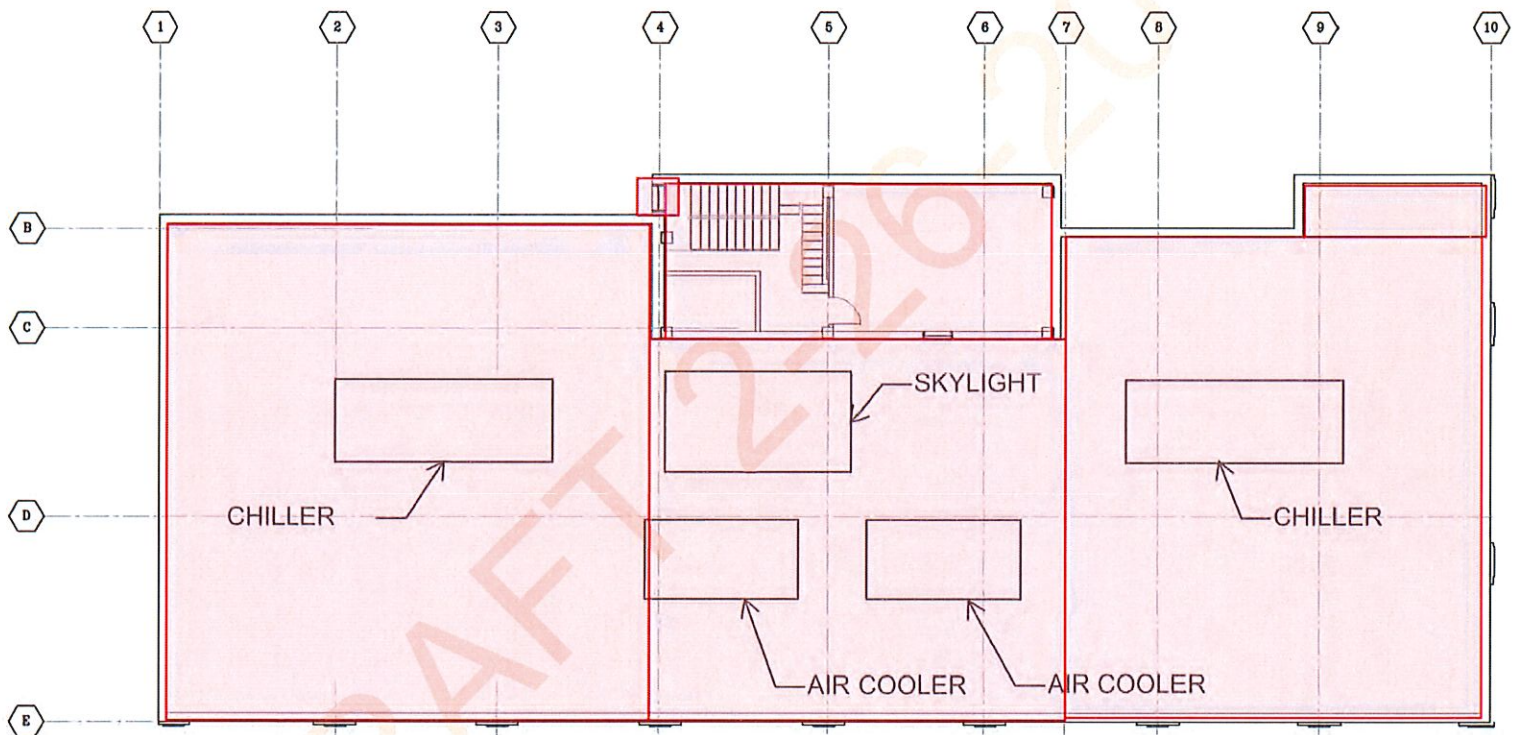

ROOF PLAN

**PART 3 ITC REMEDIAL WORK
LIGHTHOUSE PROPERTY MANAGEMENT**



**JANUARY 2018
ITC 21,648 (IA-2009-040)**